### ADDENDUM NO. 1

**Project Name:** Wadhams WWTP Improvements

Town of Westport

Essex County, New York

**CDBG Grant No:** C305168

Addendum Date: January 12, 2021

To: All Contract Bidders of Record

This addendum forms a part of the Contract Documents. All contract bidders must acknowledge receipt of this Addendum in the space provided on the Bid Form. Failure to do so may subject the bidder to disqualification.

## **CHANGES TO DRAWINGS**

1. Remove Sheet C-502 in its entirety and replace with Sheet C-502 which has been revised per Addendum No.1.

### **RESPONSES TO BIDDER QUESTIONS**

1. Q: How will the town supply the filter sand to the contractor for installation? Will the sand be stockpiled as one pile for all 4 filters for the contractor to handle as needed? Would the sand be hauled when the contractor is ready for a filter and placed for the contractor to push off with a LGP dozer? IF this method how much would the town be able to haul /day?

A: The new sand for the filters will be provided and stockpiled by the Town adjacent to the staging and laydown area shown on Sheet C-200 which is located to the west of the filters.

2. Q: Detail 3 on Sheet C-502 shows that the posts are to be installed 6' OC max, Chain link fence spec states that posts are to be installed 10' OC max, which is correct?

A: Post spacing at 10' OC max is correct. See Sheet C-502, Detail 3 which has been revised per Addendum No.1.

3. Q: Detail 3 on Sheet C-502 shows a bottom tension wire but the spec mentions installing a bottom rail, which is to be installed?

A: Bottom rail shall be installed. See Sheet C-502, Detail 3 which has been revised per Addendum No.1.

# 4. Q: Detail 3 on Sheet C-502 has a note that the Town is going to furnish and install the chain link fence as part of Alt No. 1, is this correct?

A: No, the note is incorrect. Contractor shall furnish and install chain link fence as part of AddAlternate No.1. See Sheet C-502, Detail 3 which has been revised per Addendum No.1.

## 5. Q: Please provide the estimated construction cost for this project.

A: Provided below are the estimated contract values which include allowances and all applicable alternates:


Contract 1G: \$850,000Contract 1E: \$135,000


## 6. Q: What are the funding agency requirements for this project?

A: This project is funded through a federal Community Development Block Grant (CDBG) administered by the NYS Office of Community Renewal (OCR) as well as through a Water Quality Improvements Projects (WQIP) Grant administered by the NYS Department of Environmental Conservation (DEC). Refer to Sections 007510 thru 007560 for OCR funding agency requirements. Refer to Section 007610 for DEC funding agency requirements. The following special attention is made regarding the funding requirements and forms:

- Contractors are required to provide all funding agency forms upon NOTICE OF LOW BID;
- Upon receipt of the funding program requirements forms, the awarded contract can be executed;
- Failure to provide these forms to assess the compliance with funding goals will result in rejection of the bid and the award will go to the next lowest bidder; and
- MWBE and EEO submittals and reports can be updated as the project progresses, but Waivers from MWBE requirements must be approved before a Notice to Proceed can be given, in order to prevent non-compliant costs being borne by the Town.

#### **END OF ADDENDUM NO. 1**

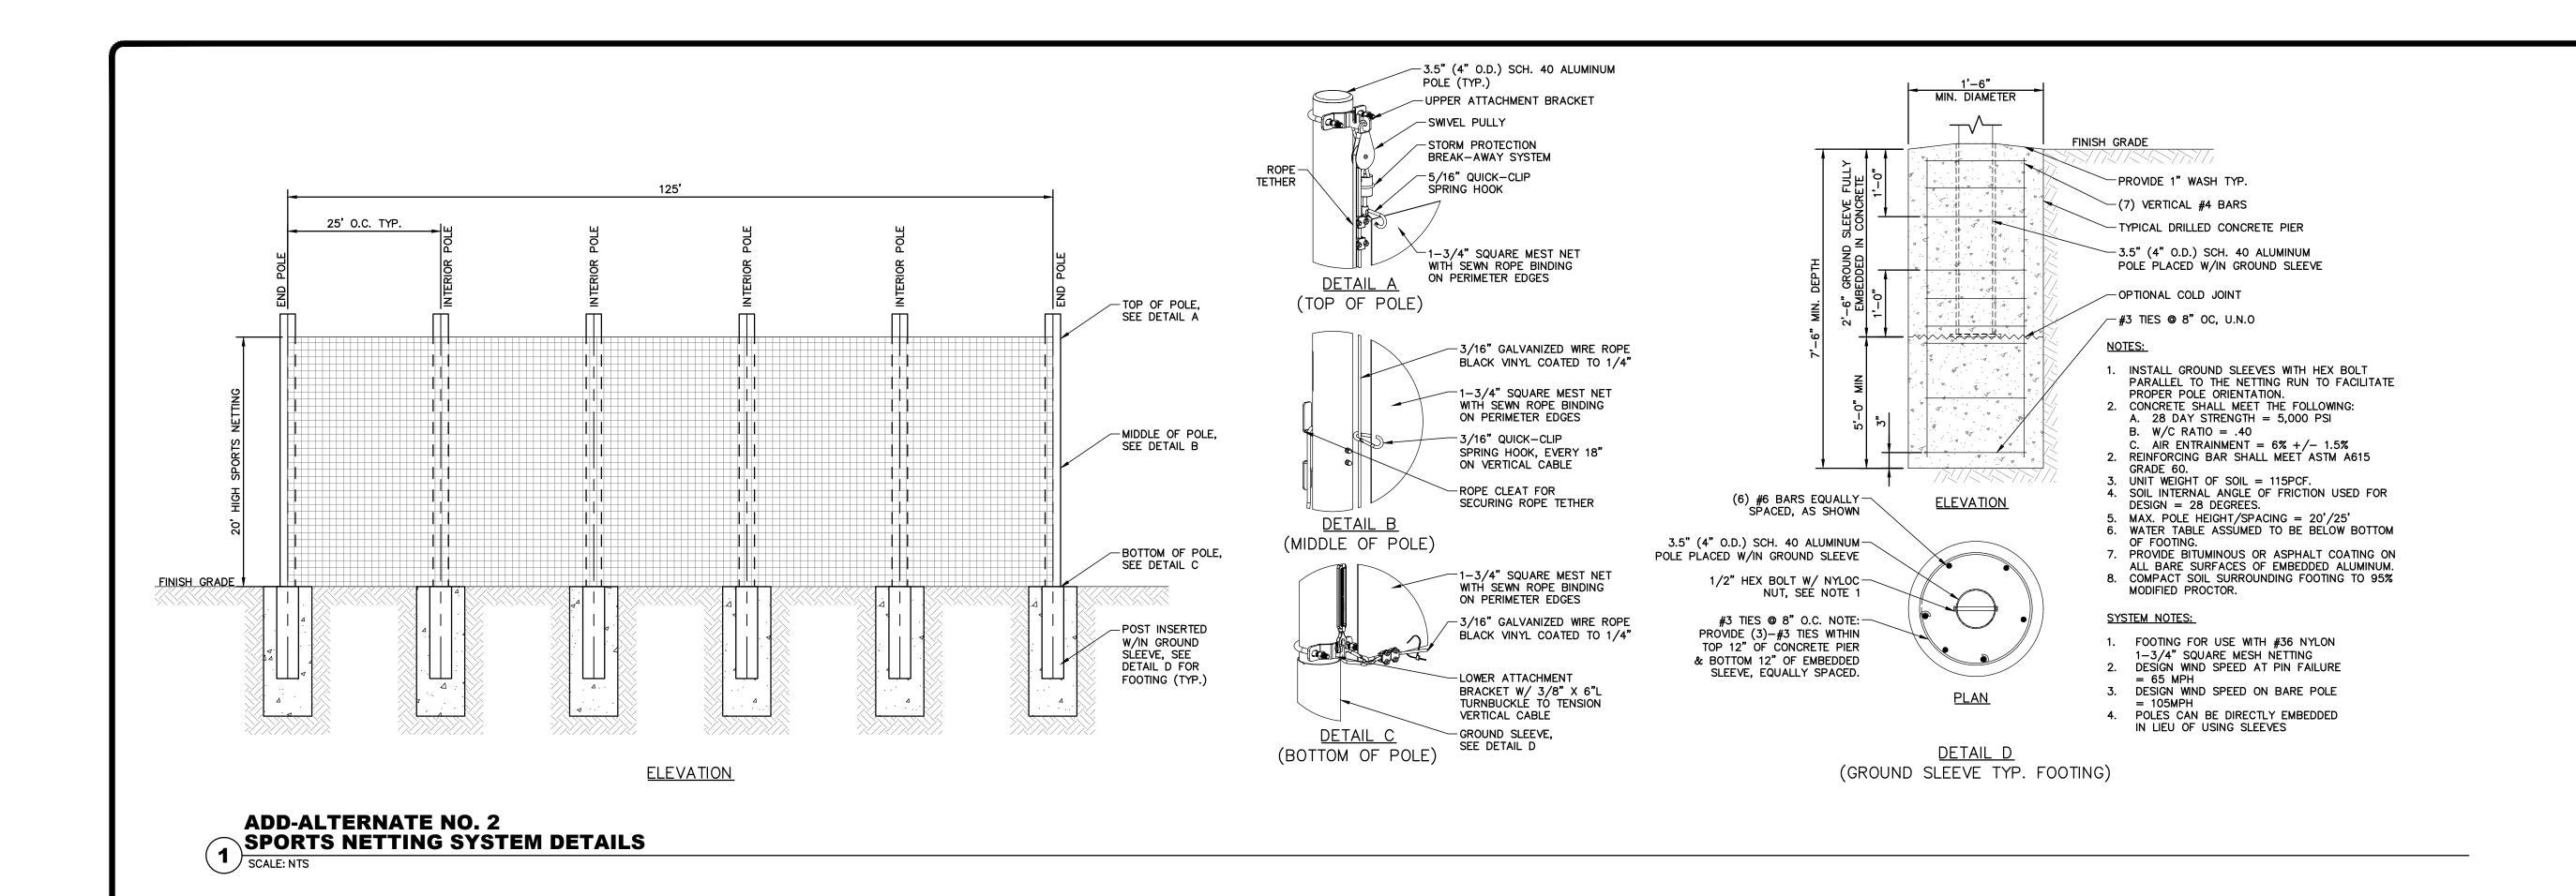

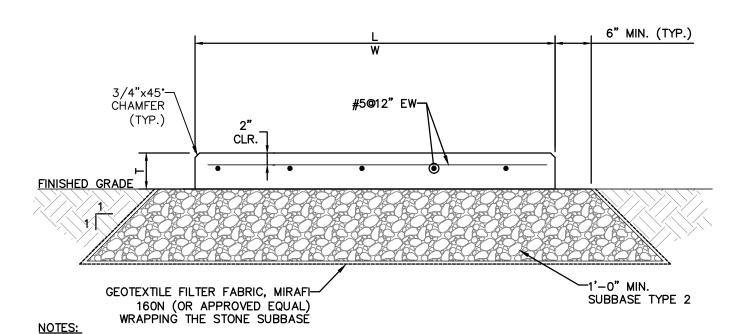

1. L= LENGTH OF EQUIPMENT BASE, PLUS 6"± EACH SIDE.

W= WIDTH OF EQUIPMENT BASE, PLUS 6 ± EACH SIDE.


W= WIDTH OF EQUIPMENT BASE, PLUS 6"± EACH SIDE.

T= 8" (UNLESS OTHERWISE SHOWN OR REQUIRED TO CONNECT TO EXISTING AND/OR PROPOSED MECHANICAL SYSTEMS)

2. ANCHOR EQUIPMENT TO PAD AS DIRECTED BY EQUIPMENT MANUFACTURER.

3. CONFIRM FINAL EQUIPMENT PAD DIMENSIONS WITH EQUIPMENT MANUFACTURER.

CONCRETE PAD - GENERATOR & PROPANE TANK
SCALE: NTS

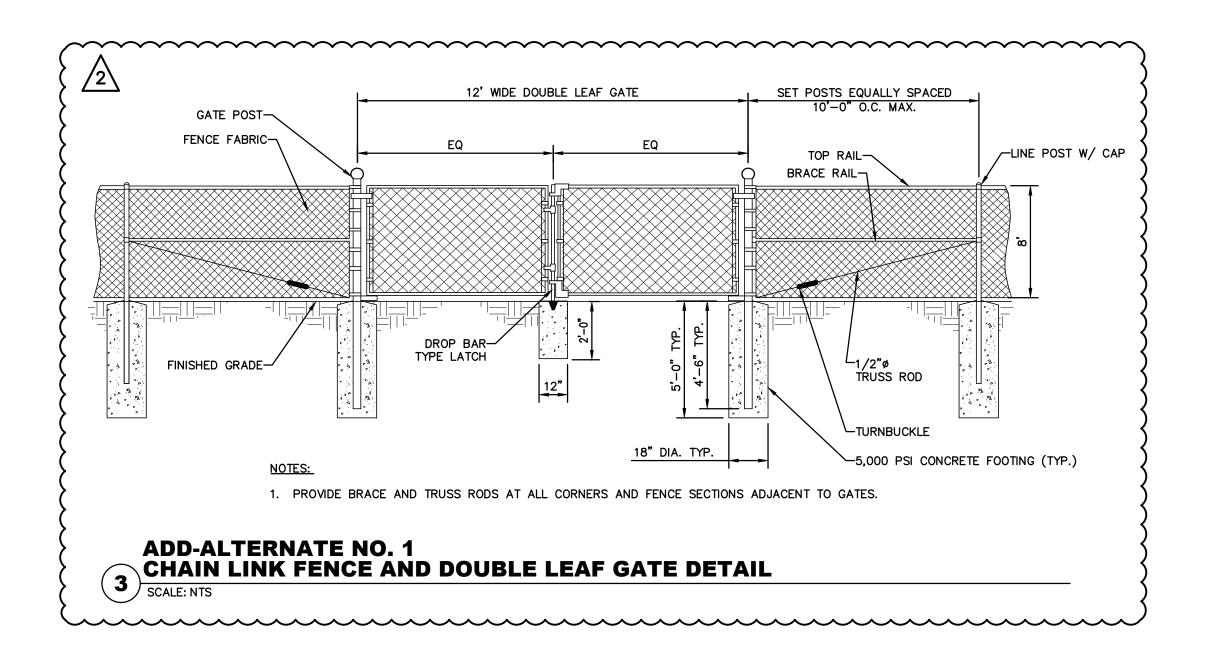

ı		SUBMITTAL / REVISIONS					
No.	DATE	DESCRIPTION	BY	REVIEWED BY:	DATE	PROJ. MANAGER:	CLD
1	12/15/2020	BID DOCUMENTS	MJD	CLD	12/11/20	CHIEF DESIGNER:	MJD
2	01/08/2021	ADDENDUM NO.1	MJD	CLD	01/08/21	DESIGNED BY:	MJD
						DRAWN BY:	AS
						CHECKED BY:	CLD
	· ·	'				'	



DATE

THE ALTERATION OF THIS MATERIAL IN ANY WAY, UNLESS DONE UNDER THE DIRECTION OF A COMPARABLE PROFESSIONAL, (I.E.) ARCHITECT FOR AN ARCHITECT, ENGINEER FOR AN ENGINEER OR LANDSCAPE ARCHITECT FOR A LANDSCAPE ARCHITECT, IS A VIOLATION OF THE NEW YORK STATE EDUCATION LAW AND/OR REGULATIONS AND IS A CLASS "A" MISDEMEANOR.



TOWN OF WESTPORT WADHAMS WWTP IMPROVEMENTS

SITE DETAILS 3

ESSEX COUNTY

**NEW YORK** 

SCALE: NONE
CONTRACT No.: G, E
MJ PROJ. No.: 1075.02
DATE: 12/15/2020

**C-502**